


QUARTERMASTER STOREHOUSE

BUILDING NO. 40

FORT UNION



THE QUARTERMASTER STOREHOUSE WAS ONE OF THREE STOREHOUSES OF IDENTICAL SIZE AND LAYOUT, BUILT AT FORT UNION 1866-67. UNLIKE THE TWO STOREHOUSES IMMEDIATELY TO THE NORTH, BUILDING NO. 40 WAS CONSTRUCTED WITH A HIPPED ROOF, ORIGINALLY COVERED IN WOOD SHINGLES BUT LATER SHEATHED IN TIN. IN 1885 THE BUILDING WAS ALTERED TO ACCOMMODATE A BOWLING ALLEY AND GYMNASIUM.

DOCUMENTATION OF FORT UNION WAS UNDERTAKEN BY THE HISTORIC AMERICAN BUILDINGS SURVEY / HISTORIC AMERICAN ENGINEERING RECORD (HABS/HAER) DIVISION OF THE NATIONAL PARK SERVICE (NPS), E. BLAINE CLIVER, CHIEF. THE PROJECT WAS SPONSORED BY FORT UNION NATIONAL MONUMENT (FOWN), NPS, GEORGE HELFRICH, ACTING SUPERINTENDENT. PROJECT PLANNING WAS COORDINATED BY PAUL DOLINSKY, CHIEF, HABS; AND BY BOB HARTZLER, EXHIBIT SPECIALIST, FOWN. THE FIELD WORK WAS UNDERTAKEN AND THE MEASURED DRAWINGS WERE PRODUCED BY PROJECT SUPERVISOR MARK SCHARA, HABS ARCHITECT; BY HABS ARCHITECT RAUL VAZQUEZ; AND BY ARCHITECTS EDWARD L. BYRDY JR. (CATHOLIC UNIVERSITY OF AMERICA) AND JENNIFER L. MOST (MASSACHUSETTS INSTITUTE OF TECHNOLOGY).

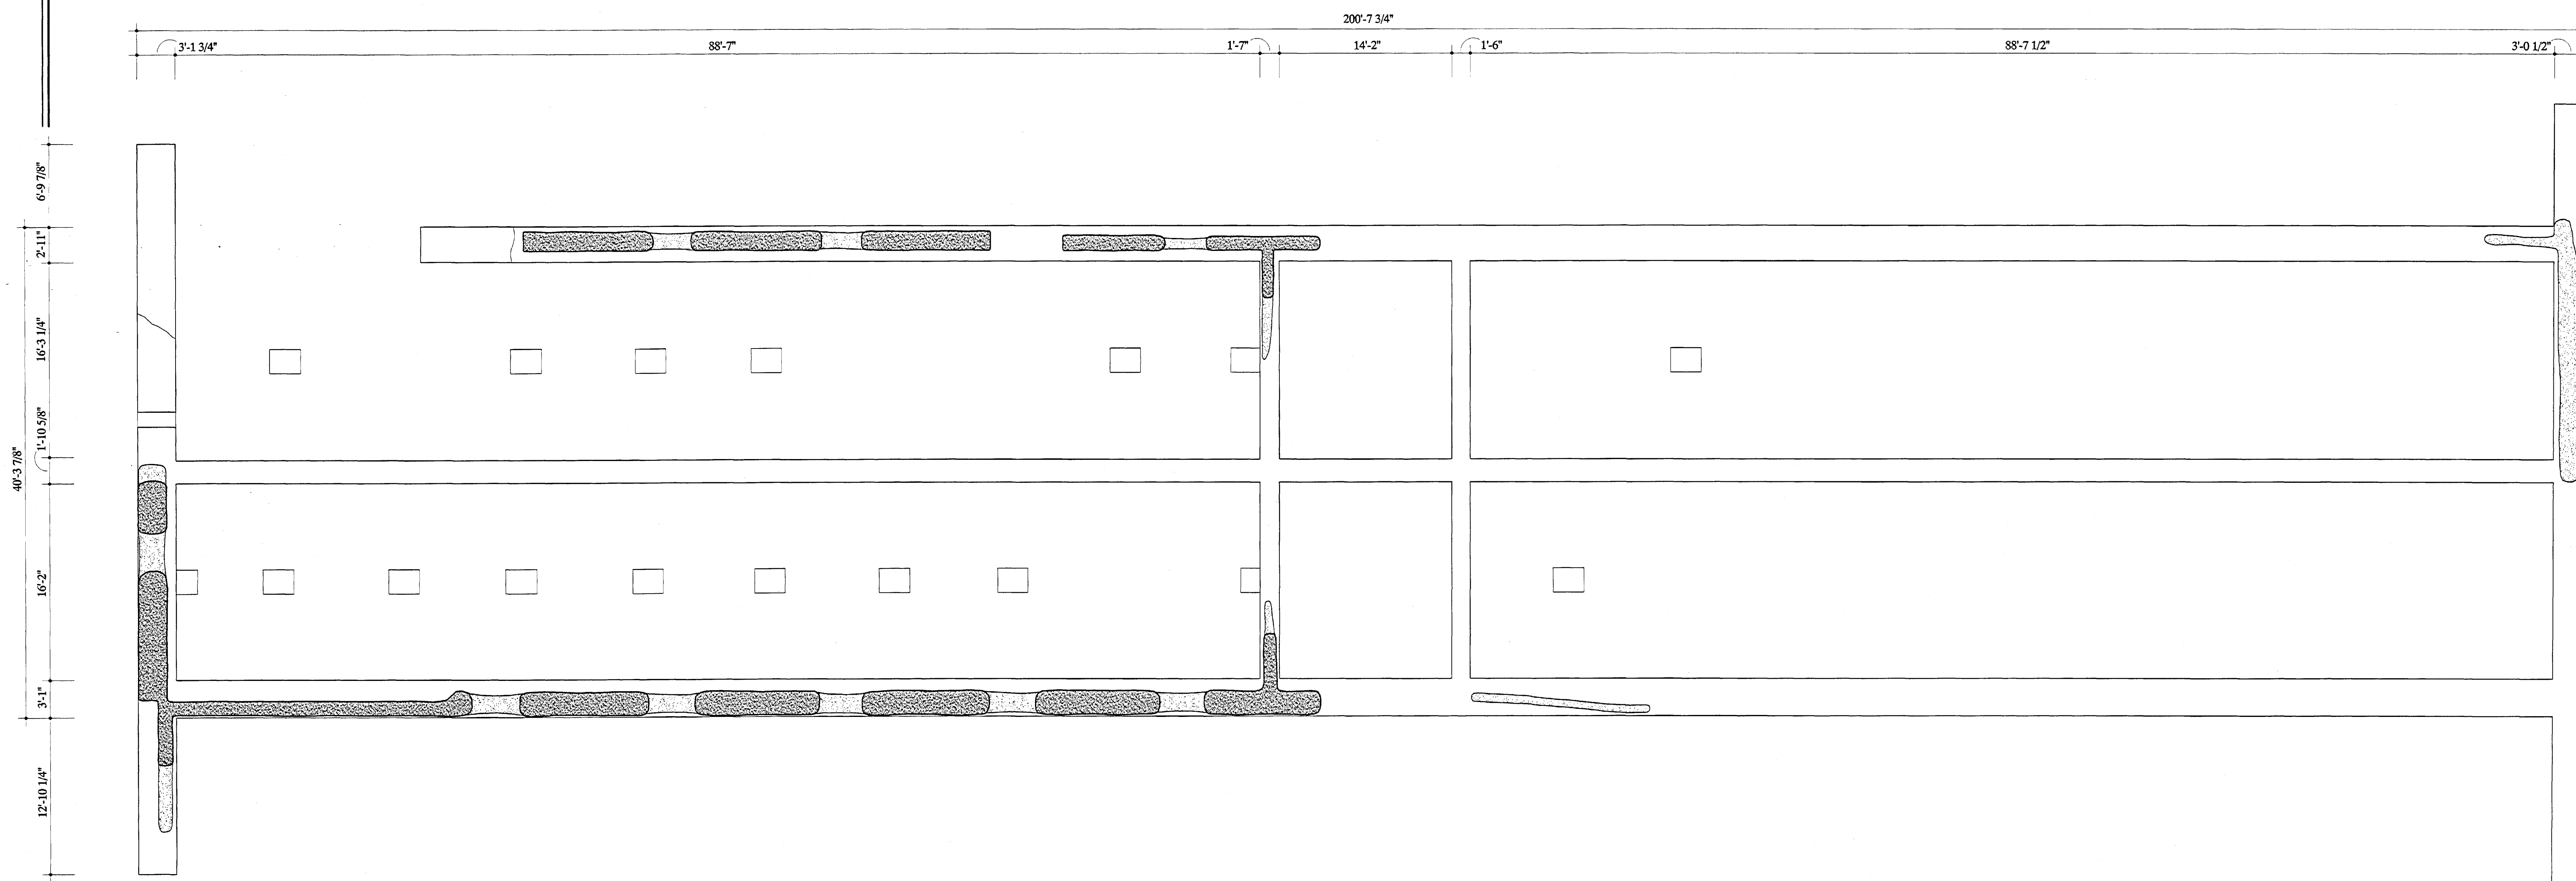

PLAN

3/16" = 1'-0" 1:64

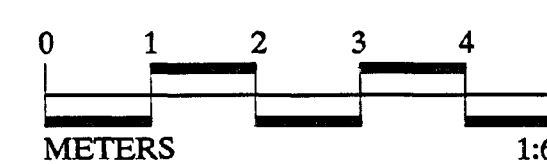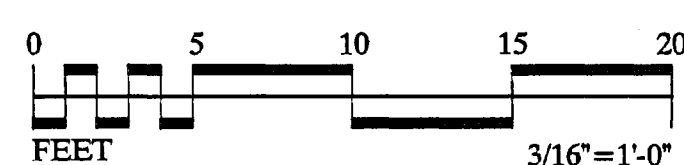

DRAWN BY: JENNIFER L. MOST

FORT UNION PROJECT, 2001

UNITED STATES DEPARTMENT OF THE INTERIOR

STATE HIGHWAY 161

FORT UNION · QUARTERMASTER STOREHOUSE

WATROUS VICINITY

MORA COUNTY

NEW MEXICO

SHEET 1
OF 1 SHEET

HISTORIC AMERICAN
BUILDINGS SURVEY
NM-104-X

UNIVERSITY OF
MICHIGAN



1500 N.M. 1-1-1

H.S.P. N.M. 164. X. 2.

UNIVERSITY OF CALIFORNIA
D 16

