


QUARTERMASTER STOREHOUSE

BUILDING NO. 39




FORT UNION

THE QUARTERMASTER STOREHOUSE WAS CONSTRUCTED 1866-67. IN PLAN IT WAS DIVIDED INTO NINE SMALL ROOMS, FOR THE STORAGE AND DISBURSEMENT OF SMALL ITEMS SUCH AS TOOLS, HARDWARE, AND EQUESTRIAN EQUIPMENT.

DOCUMENTATION OF FORT UNION WAS UNDERTAKEN BY THE HISTORIC AMERICAN BUILDINGS SURVEY / HISTORIC AMERICAN ENGINEERING RECORD (HABS/HAER) DIVISION OF THE NATIONAL PARK SERVICE (NPS), E. BLAINE CLIVER, CHIEF. THE PROJECT WAS SPONSORED BY FORT UNION NATIONAL MONUMENT (FOWN), NPS, GEORGE HELFRICH, ACTING SUPERINTENDENT. PROJECT PLANNING WAS COORDINATED BY PAUL DOLINSKY, CHIEF, HABS; AND BY BOB HARTZLER, EXHIBIT SPECIALIST, FOWN. THE FIELD WORK WAS UNDERTAKEN AND THE MEASURED DRAWINGS WERE PRODUCED BY PROJECT SUPERVISOR MARK SCHARA, HABS ARCHITECT; BY HABS ARCHITECT RAUL VAZQUEZ; AND BY ARCHITECTS EDWARD L. BYRDY JR. (CATHOLIC UNIVERSITY OF AMERICA) AND JENNIFER L. MOST (MASSACHUSETTS INSTITUTE OF TECHNOLOGY).

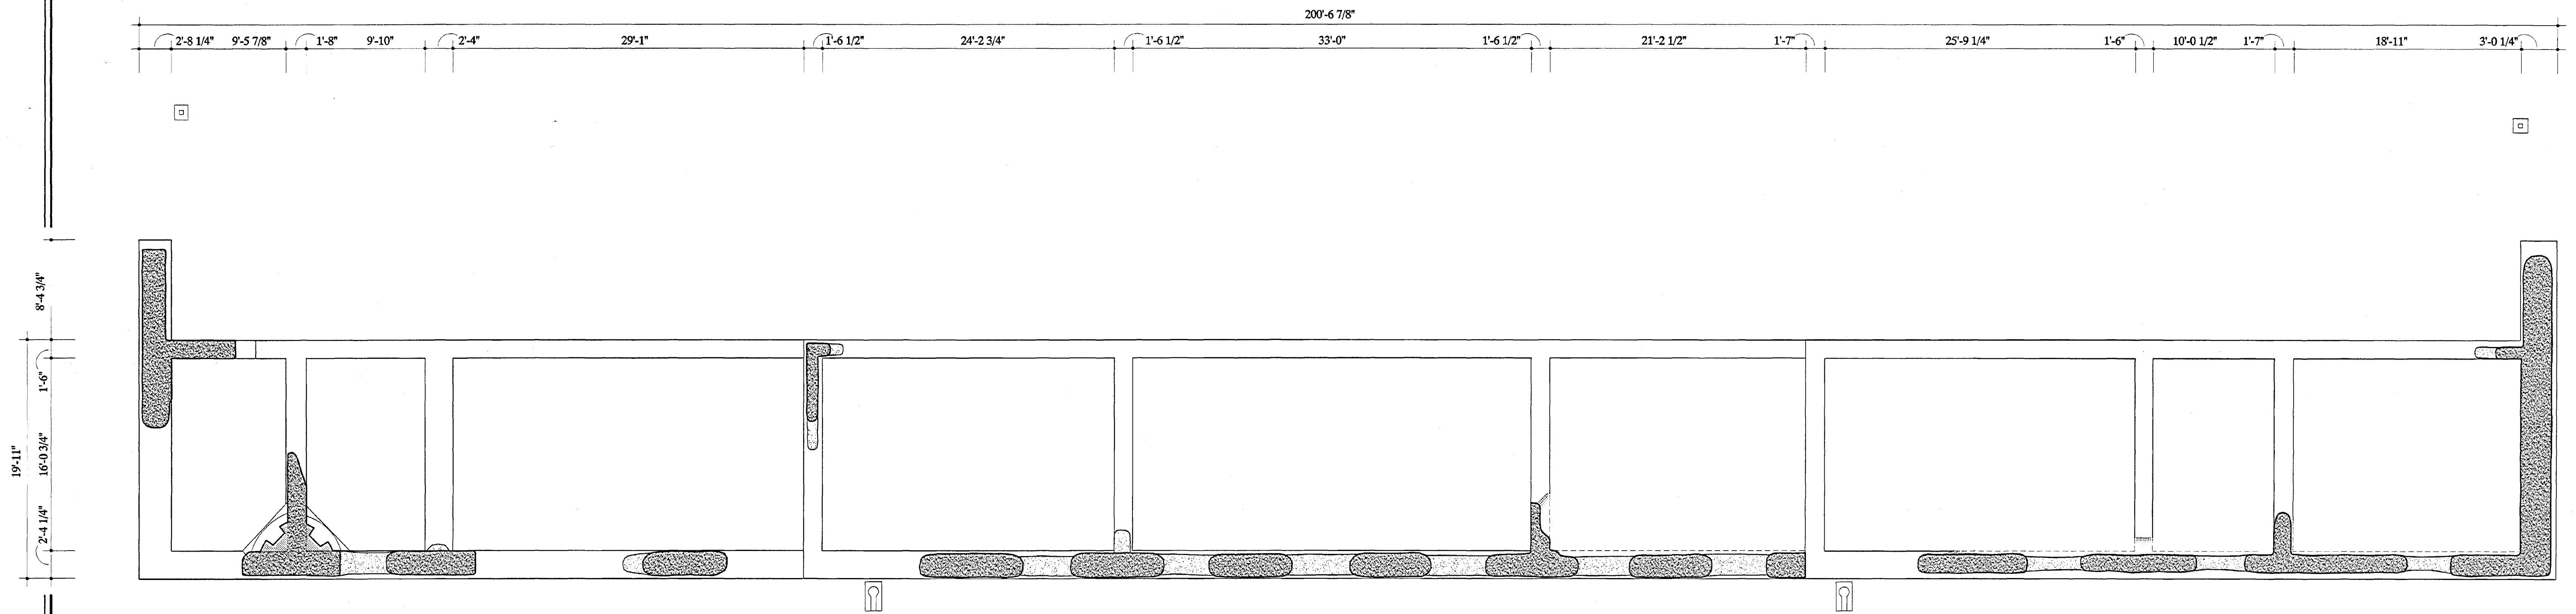

PLAN
3/16" = 1'-0" 1:64

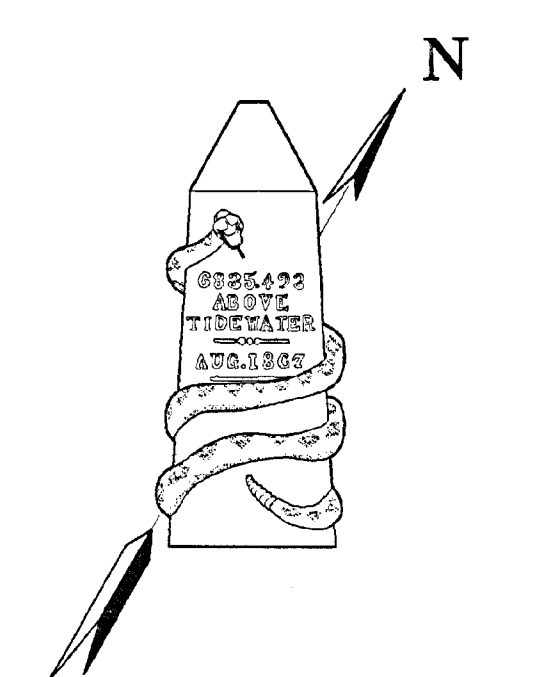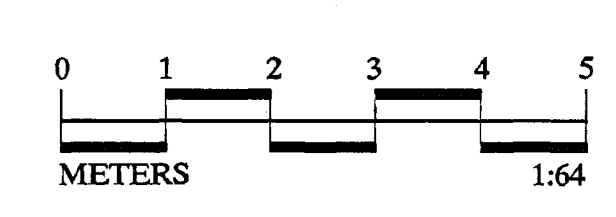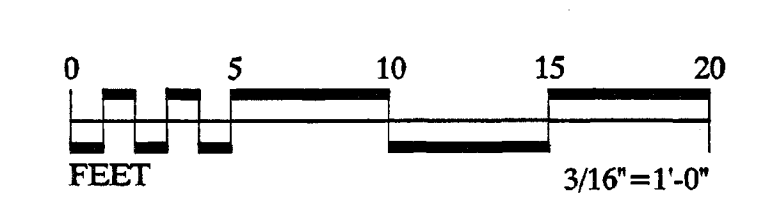



14825. NM. 164. W. 1




